

**1 Ground Floor - Alcohol Licencing Plan**  
 1 : 100

- SL Fire Alarm Call Point with Fire Action Sign adjacent, the contents of which should be based on the Fire Safety and Evacuation Plan for the premises.
  - FFF Security Lock (Door, which may be provided with special fastening as described on plan).
  - Control panel sounders
  - Control panel illuminated signals
  - Control panel sounders and illuminated signals
  - SCA Self-closing door incorporating an automatic release e.g., Electro Magnetic Door Holder.
  - PB Doors which are to be provided with a panic bolt. There should be a notice adjacent to the fastening indicating the method of opening (minimum 5mm lettering).
  - SF Doors that have only a simple fastening which is easily and immediately operable by a person on his/her way out without use of a key, e.g., barrel bolts, right latch, lever handle, etc.
  - TP Fire Alarm Telephone point.
  - VP A panel of clear glass in the door or adjacent partition shown on plan. It should be of an appropriate size and in a suitable position which gives the occupant of the inner room early visual warning of fire. This glass should be Fire Resisting if the door or partition is shown as such.
  - S Door assembly, which is able to resist the passage of smoke when, tested in accordance with the British Standard in force at the date of manufacture.
  - Fire Extinguisher: e.g. 13A or 34B. Number indicates the extinguishing capability and the letter indicates the class of fire that the extinguisher is suitable for. For further information see our guidance note FSGN 8.
  - Aqueous Film Forming Foam Extinguisher
  - Water Fire Extinguisher
  - Fire Blanket in container
  - Carbon Dioxide Fire Extinguisher
  - Dry Powder Extinguisher
  - Foam Fire Extinguisher
  - Hydraulic hose reel. A number following this symbol indicates the length of the tubing in metres.
  - Sand Bucket
  - Area covered by Fixed Fire Extinguisher installation (i.e. Co2)
  - Area covered by Automatic Sprinkler installation.
  - Area covered with a system of Escape Lighting that will illuminate the area upon failure of the normal lighting power supply, to a sufficient standard to enable persons to leave the area safely. The escape lighting system should conform to the British Standard current at the time of its installation and a certificate to this effect kept.
  - Area covered by Automatic Heat Detectors
  - Area covered by Automatic Heat Detectors
  - Area covered by Automatic Smoke Detectors
  - Area covered by Automatic Smoke Detectors, mounted in ceiling void
  - PR Area covered by Pressurisation system
  - MSE Area covered by Mechanical Smoke Extraction
  - NSE Area covered by Natural Smoke Extraction
  - POC Pressurisation Override Control
- Boxes below indicate signs. The following codes show the wording displayed on the notices.  
 All notices should normally conform to the British Standard for signs which is current at the date of installation and the minimum size of lettering is as indicated below unless otherwise shown adjacent to the code on plan.
- S22 Additional Notes Directional arrow
  - S22 Notice suspended above head height at right angles to the escape route with the graphic symbol on the approach side.
  - S22 As above but with the graphic symbol on both sides of the notice.
  - S22 Indicates that the notice is internally illuminated.
  - S22 Fire exit, exit or emergency exit notice graphic symbol.
  - S23 Slide to open (with arrow indicating direction).
  - S20 Fire escape keep clear.
  - S19 Gangway keep clear.
  - S17 Secure door open when premises are occupied.
  - S8 Highly flammable material - keep locked.
  - S8 Highly flammable material - keep locked.
  - S2 No smoking.
  - S13 Fire door keep shut.
  - S14 Fire door keep locked.

PUBLIC AREA SCHEME			
Level	Area (sqm)	Area (sqft)	
Ground Floor	787	8475	
First Floor	708	7622	
	1495	16097	

Rev	Date	Description	By
1	28.02.17	Issuing revised after site visit	AZ

**SOUTH HARROW**  
 Unit 1B, Northolt Rd Retail Park, Harrow, HA2 0EG

Client: Tjx Europe

**HOMESENSE**

Drawn by: AZ

Checked by: PS

CMC Project Sp. z o.o. Spółka komandytowa.  
 ul. Gęsia 5/200, 31-535 Kraków.  
 tel. +48 12 4111313

CMC projekt

Drawing title: **Ground Floor - Alcohol Licencing Plan**

Drawing number: **HS\_HAR\_C02\_LP**

Project status: **AS BUILT**

Scale: 1:100 d @A0 revision: 1  
 Date: JUNE 2018




This drawing to be read in conjunction with all relevant consultants, sub-contractors and specialists drawings.




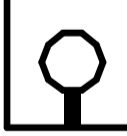


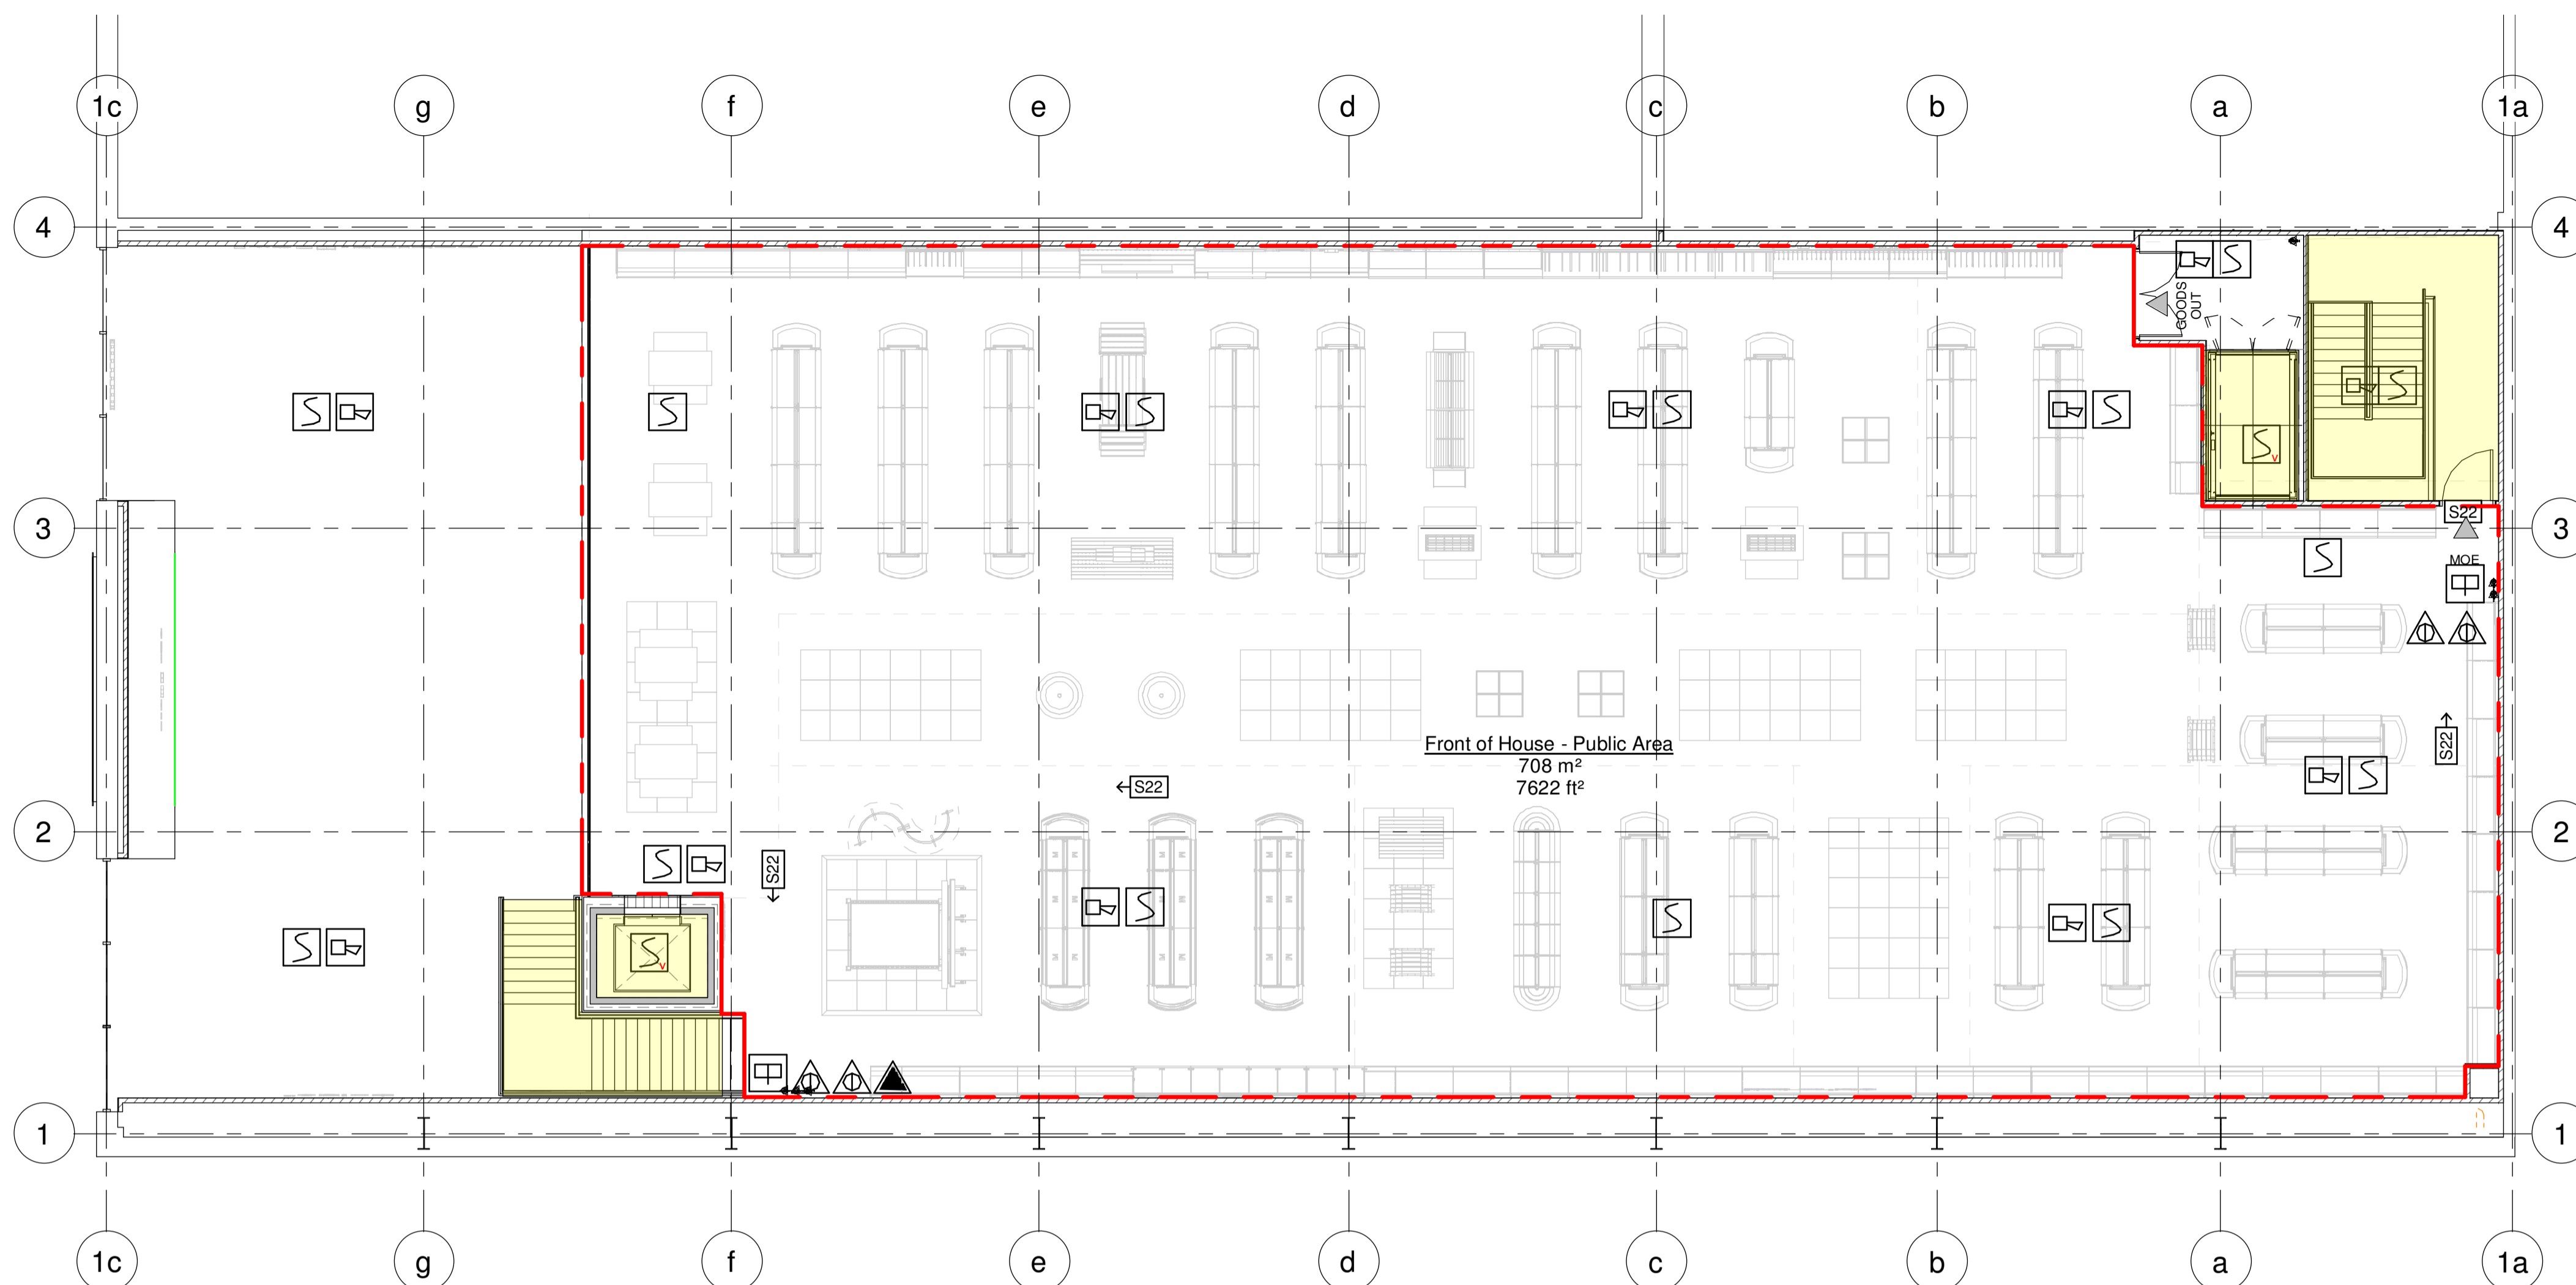


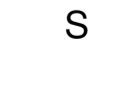












All dimensions and levels are to be checked on site before any construction begins and any discrepancies are to be reported to the relevant Project Manager.










Partial Service : Any discrepancies or any other information are to be advised to the relevant Project Manager and direction sought before the implementation of the detail.


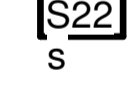
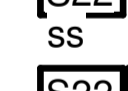

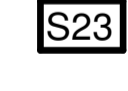
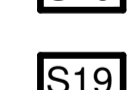
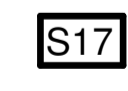
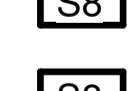
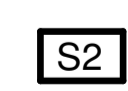
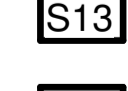


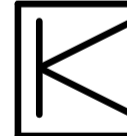

This drawing should not be scaled. The contractor should check all dimensions on site, any error or omission should be reported to CMC Projekt



**1 First Floor - Alcohol Licencing Plan**  
1 : 100

-  SL Security Lock (Door, which may be provided with special fastening as described on plan).
-  FFF Doors which are to be free from all fastenings (other than a ball or roller fastening or a lever handled latch). This is to ensure that the door is always available for escape from either side.
-  Control panel sounders
-  Control panel illuminated signals
-  Control panel sounders and illuminated signals
-  SCA Self-closing door incorporating an automatic release e.g., Electro Magnetic Door Holder.
-  PB Doors which are to be provided with a panic bolt. There should be a notice adjacent to the fastening indicating the method of opening (minimum 5mm lettering).
-  SF Doors that have only a simple fastening which is easily and immediately operable by a person on his/her way out without use of a key, e.g., barrel bolts, night latch, lever handle, etc.
-  TP Fire Alarm Telephone point.
-  VP A panel of clear glass in the door or adjacent partition shown on plan. It should be of an appropriate size and in a suitable position which gives the occupant of the inner room early visual warning of fire. This glass should be Fire Resisting if the door or partition is shown as such.
-  S Door assembly, which is able to resist the passage of smoke when, tested in accordance with the British Standard in force at the date of manufacture.
-  Fire Extinguisher: e.g. 13A or 34B. Number indicates the extinguishing capability and the letter indicates the class of fire that the extinguisher is suitable for. For further information see our guidance note FSGN 8.
-  Aqueous Film Forming Foam Extinguisher
-  Water Fire Extinguisher
-  Fire Blanket in container
-  Carbon Dioxide Fire Extinguisher
-  Dry Powder Extinguisher
-  Foam Fire Extinguisher
-  Hydraulic hose reel. A number following this symbol indicates the length of the tubing in metres.
-  Sand Bucket
-  Area covered by Fixed Fire Extinguisher installation (i.e. Co2)
-  Area covered by Automatic Sprinkler installation.

-  Area covered with a system of Escape Lighting that will illuminate the area upon failure of the normal lighting power supply, to a sufficient standard to enable persons to leave the area safely. The escape lighting system should conform to the British Standard current at the time of its installation and a certificate to this effect kept.
-  Area covered by Automatic Heat Detectors
-  Area covered by Automatic Heat Detectors
-  Area covered by Automatic Smoke Detectors
-  Area covered by Automatic Smoke Detectors (Smoke Detector mounted on slab in void)
-  PR Area covered by Pressurisation system
-  MSE Area covered by Mechanical Smoke Extraction
-  NSE Area covered by Natural Smoke Extraction
-  POC Pressurisation Override Control

- Boxes below indicate signs. The following codes show the wording displayed on the notices.
- All notices should normally conform to the British Standard for signs which is current at the date of installation and the minimum size of lettering is as indicated below unless otherwise shown adjacent to the code on plan.
-  **S22** → Additional Notes Directional arrow
  -  **S22** S Notice suspended above head height at right angles to the escape route with the graphic symbol on the approach side.
  -  **S22** SS As above but with the graphic symbol on both sides of the notice.
  -  **S22** ◀▶ Indicates that the notice is internally illuminated.
  -  **S22** Fire exit, exit or emergency exit notice graphic symbol.
  -  **S23** Slide to open (with arrow indicating direction).
  -  **S20** Fire escape keep clear
  -  **S19** Gangway keep clear.
  -  **S17** Secure door open when premises are occupied.
  -  **S8** Highly flammable material - keep locked.
  -  **S8** Highly flammable material - keep locked.
  -  **S2** No smoking.
  -  **S13** Fire door keep shut.
  -  **S14** Fire door keep locked.

PUBLIC AREA SCHEME		
Level	Area (sqm)	Area (sqft)
Ground Floor	787	8475
First Floor	708	7622
	1495	16097

Rev	Date	Description	By
1	2018-07-20	Drawing revised after site visit	AZ


**SOUTH HARROW**  
Unit 1B, Northolt Rd Retail Park,  
Harrow, HA2 0EG

client: TJX Europe

HOMESENSE

drawn by: AZ

checked by: PS

 CMC Projekt Sp. z o.o. Spółka komandytowa,  
ul. Gęsia 8/300, 31-535 Kraków.  
tel: +48 12 4111171  
Copyright © reserved by CMC and it is forbidden for the customer that has not agreed or distributed, or to any other person or organization without prior written consent of the CMC. All dimensions to be provided on the plan to any other person, without prior written consent of the CMC. The customer shall be responsible for the accuracy of the data provided on the plan. The customer shall be responsible for the accuracy of the data provided on the plan.

drawing title:  
**First Floor - Alcohol Licencing Plan**

drawing number:  
**HS\_HAR\_C12\_LP**

project status:  
AS BUILT

scale: 1:100 d @A1 revision: 1  
date: JUNE 2018